
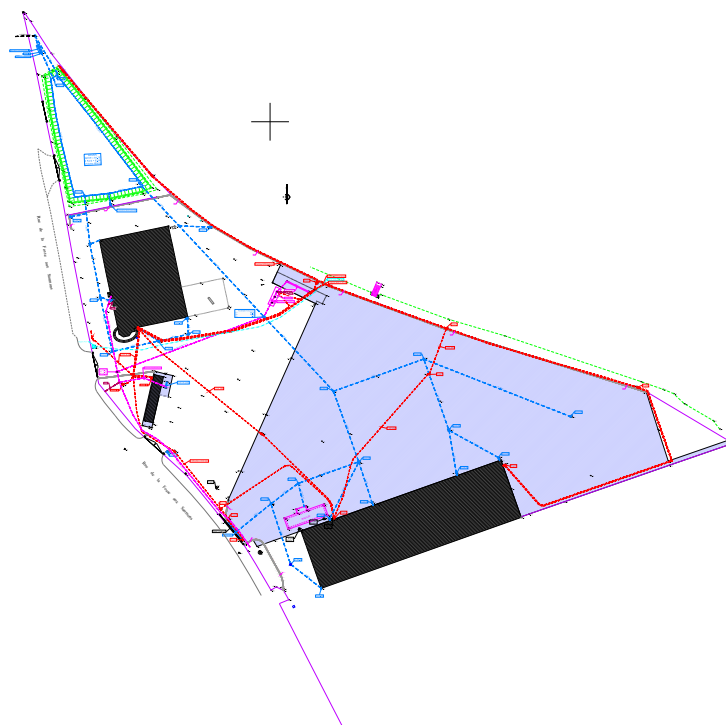


COLAS

WE OPEN THE WAY

COLAS Agence Bourgogne Ouest
48, Chemin des Ruelles
89380 APPOIGNY
Tél: 03 86 53 59 50
E-mail: yonne@colas.com

Entreprise COVED - Site de SENS
Plan RECOLEMENT - VRD
28/02/2024 - ECHELLE: 1/2500

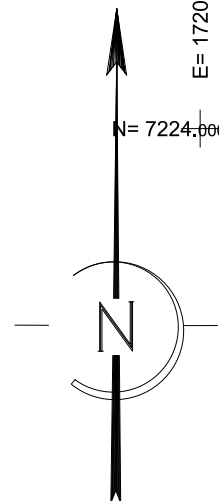

N= 7224.000

N= 7224.000

N= 7223.750

N= 7223.750

N= 7223.500

N= 7223.500

E= 1719.750

E= 1720.000